

AMENDMENT OF SOLICITATION/MODIFICATION OF CONTRACT				1. CONTRACT ID CODE	PAGE 1	OF PAGES 3
2. AMENDMENT/MODIFICATION NO. 0001		3. EFFECTIVE DATE 09/09/2026		4. REQUISITION/PURCHASE REQ. NO. 7375939		5. PROJECT NO. (If applicable)
6. ISSUED BY CG MCAS Cherry Point FACILITIES, ROICC B-87, 748 Roosevelt Blvd. PSC BOX 8006 MCAS CHERRY POINT NC 28533-0012		Code N40085		7. ADMINISTERED BY (If other than item 6.)		Code
8. NAME AND ADDRESS OF CONTRACTOR (No., street, county, State and ZIP Code) AMENDMENT MUST BE ACKNOWLEDGED WITH YOUR PROPOSAL				☒	9A. AMENDMENT OF SOLICITATION N400857375939	
					9B. DATED (SEE ITEM 11)	
				☐	10A. MODIFICATION OF CONTRACT/ORDER NO.	
					10B. DATED (SEE ITEM 13)	
CODE		FACILITY CODE				
11. THIS ITEM ONLY APPLIES TO AMENDMENTS OF SOLICITATIONS						
☒ The above numbered solicitation is amended as set forth in item 14. The hour and date specified for receipt of Offers ☐ is extended ☒ is not extended. Offers must acknowledge receipt of this amendment prior to the hour and date specified in the solicitation or as amended, by one of the following methods: (a) By completing items 8 and 15, and returning 1 copy of the amendment; (b) By acknowledging receipt of this amendment on each copy of the offer submitted; or (c) By separate letter or telegram which includes a reference to the solicitation and amendment numbers. FAILURE OF YOUR ACKNOWLEDGMENT TO BE RECEIVED AT THE PLACE DESIGNATED FOR THE RECEIPT OF OFFERS PRIOR TO THE HOUR AND DATE SPECIFIED MAY RESULT IN REJECTION OF YOUR OFFER. If by virtue of this amendment you desire to change an offer already submitted, such change may be made by telegram or letter, provided each telegram or letter makes reference to the solicitation and this amendment, and is received prior to the opening hour and date specified.						
12. ACCOUNTING AND APPROPRIATION DATA (if required)						
13. THIS ITEM APPLIES ONLY TO MODIFICATIONS OF CONTRACTS/ORDERS, IT MODIFIES THE CONTRACT/ORDER NO. AS DESCRIBED IN ITEM 14.						
☐	A. THIS CHANGE ORDER IS ISSUED PURSUANT TO: (Specify authority) THE CHANGES SET FORTH IN ITEM 14. ARE MADE IN THE CONTRACT ORDER NO. IN ITEM 10A.					
☐	B. THE ABOVE NUMBERED CONTRACT/ORDER IS MODIFIED TO REFLECT THE ADMINISTRATION CHANGES (such as changes in paying office, appropriation date, etc.) SET FORTH IN ITEM 14, PURSUANT TO THE AUTHORITY OF FAR 43.103 (b).					
☐	C. THIS SUPPLEMENTAL AGREEMENT IS ENTERED INTO PURSUANT TO AUTHORITY OF:					
☐	D. OTHER: (specify type of modification and authority)					
E. IMPORTANT: Contractor ☐ is not ☐ is required to sign this document and return original to the issuing office.						
14. DESCRIPTION OF AMENDMENT/MODIFICATION (Organized by UCF section headings, including solicitation/contract subject matter where feasible.)						
PROJECT XK11237, REPAIR AND UPGRADE BUILDING 4034, Station Marine Corps Air Station Cherry Point, NC The proposed PPI end date of 10 September 2026 by 1400 remains unchanged. The proposal due date of 16 September 2026 by 1500 remains unchanged. The purpose of this amendment is to answer pre-proposal inquiries (PPIs). See attached.						
15A. NAME AND TITLE OF SIGNER (Type or print)				16A. NAME AND TITLE OF CONTRACTING OFFICER (Type or print)		
15B. CONTRACTOR/OFFEROR (Same as Item 8)		15C. DATE SIGNED		16B. UNITED STATES OF AMERICA BY		16C. DATE SIGNED
(Signature of person authorized to sign)				(Signature of Contracting Officer)		
NSN 7540-01-152-8070 PREVIOUS EDITION UNUSABLE		30-105		STANDARD FORM 30 (REV.1-83) Prescribed by GSA		0224-3(10-90)

RFI Responses:


1. Please provide the Government's estimated cost range for this project. This information is requested to determine whether a bid bond will be required and to allow our surety to evaluate the appropriate bonding limits, as the estimated cost range is required for their review. Providing this information in advance will help avoid the unnecessary risk associated with requesting a bid bond on the day of bid submission and ensure sufficient time for the surety to issue the bond, allowing us to comply with the solicitation's Bond Requirements, which require the bid bond to be submitted with the proposal.

Response: Between \$10,000,000.00 and \$25,000,000.00.

2. Please confirm the Liquidated Damages for this project - \$15,000 per day for phases 1-3 and \$75,000 per day for phase 4.

Response: The numbers for LDs for this project are listed correctly on the RFP.


3. Lines generally denote operable. I can't see how or why these openings wouldn't be fixed. Clarification please?

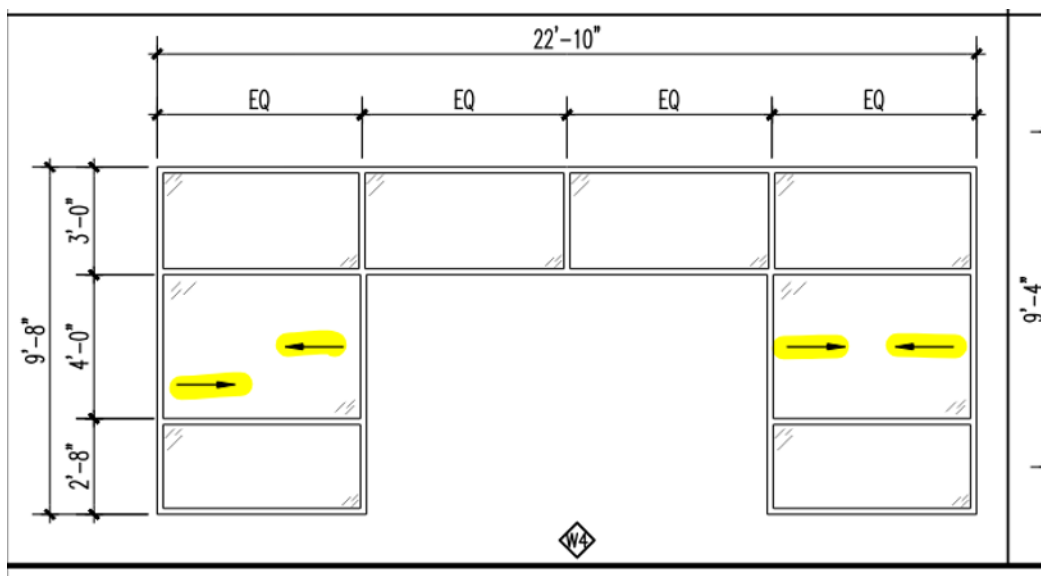

Response: See attached updated drawing


UNCLASSIFIED//FOR OFFICIAL USE ONLY

WINDOW TYPES

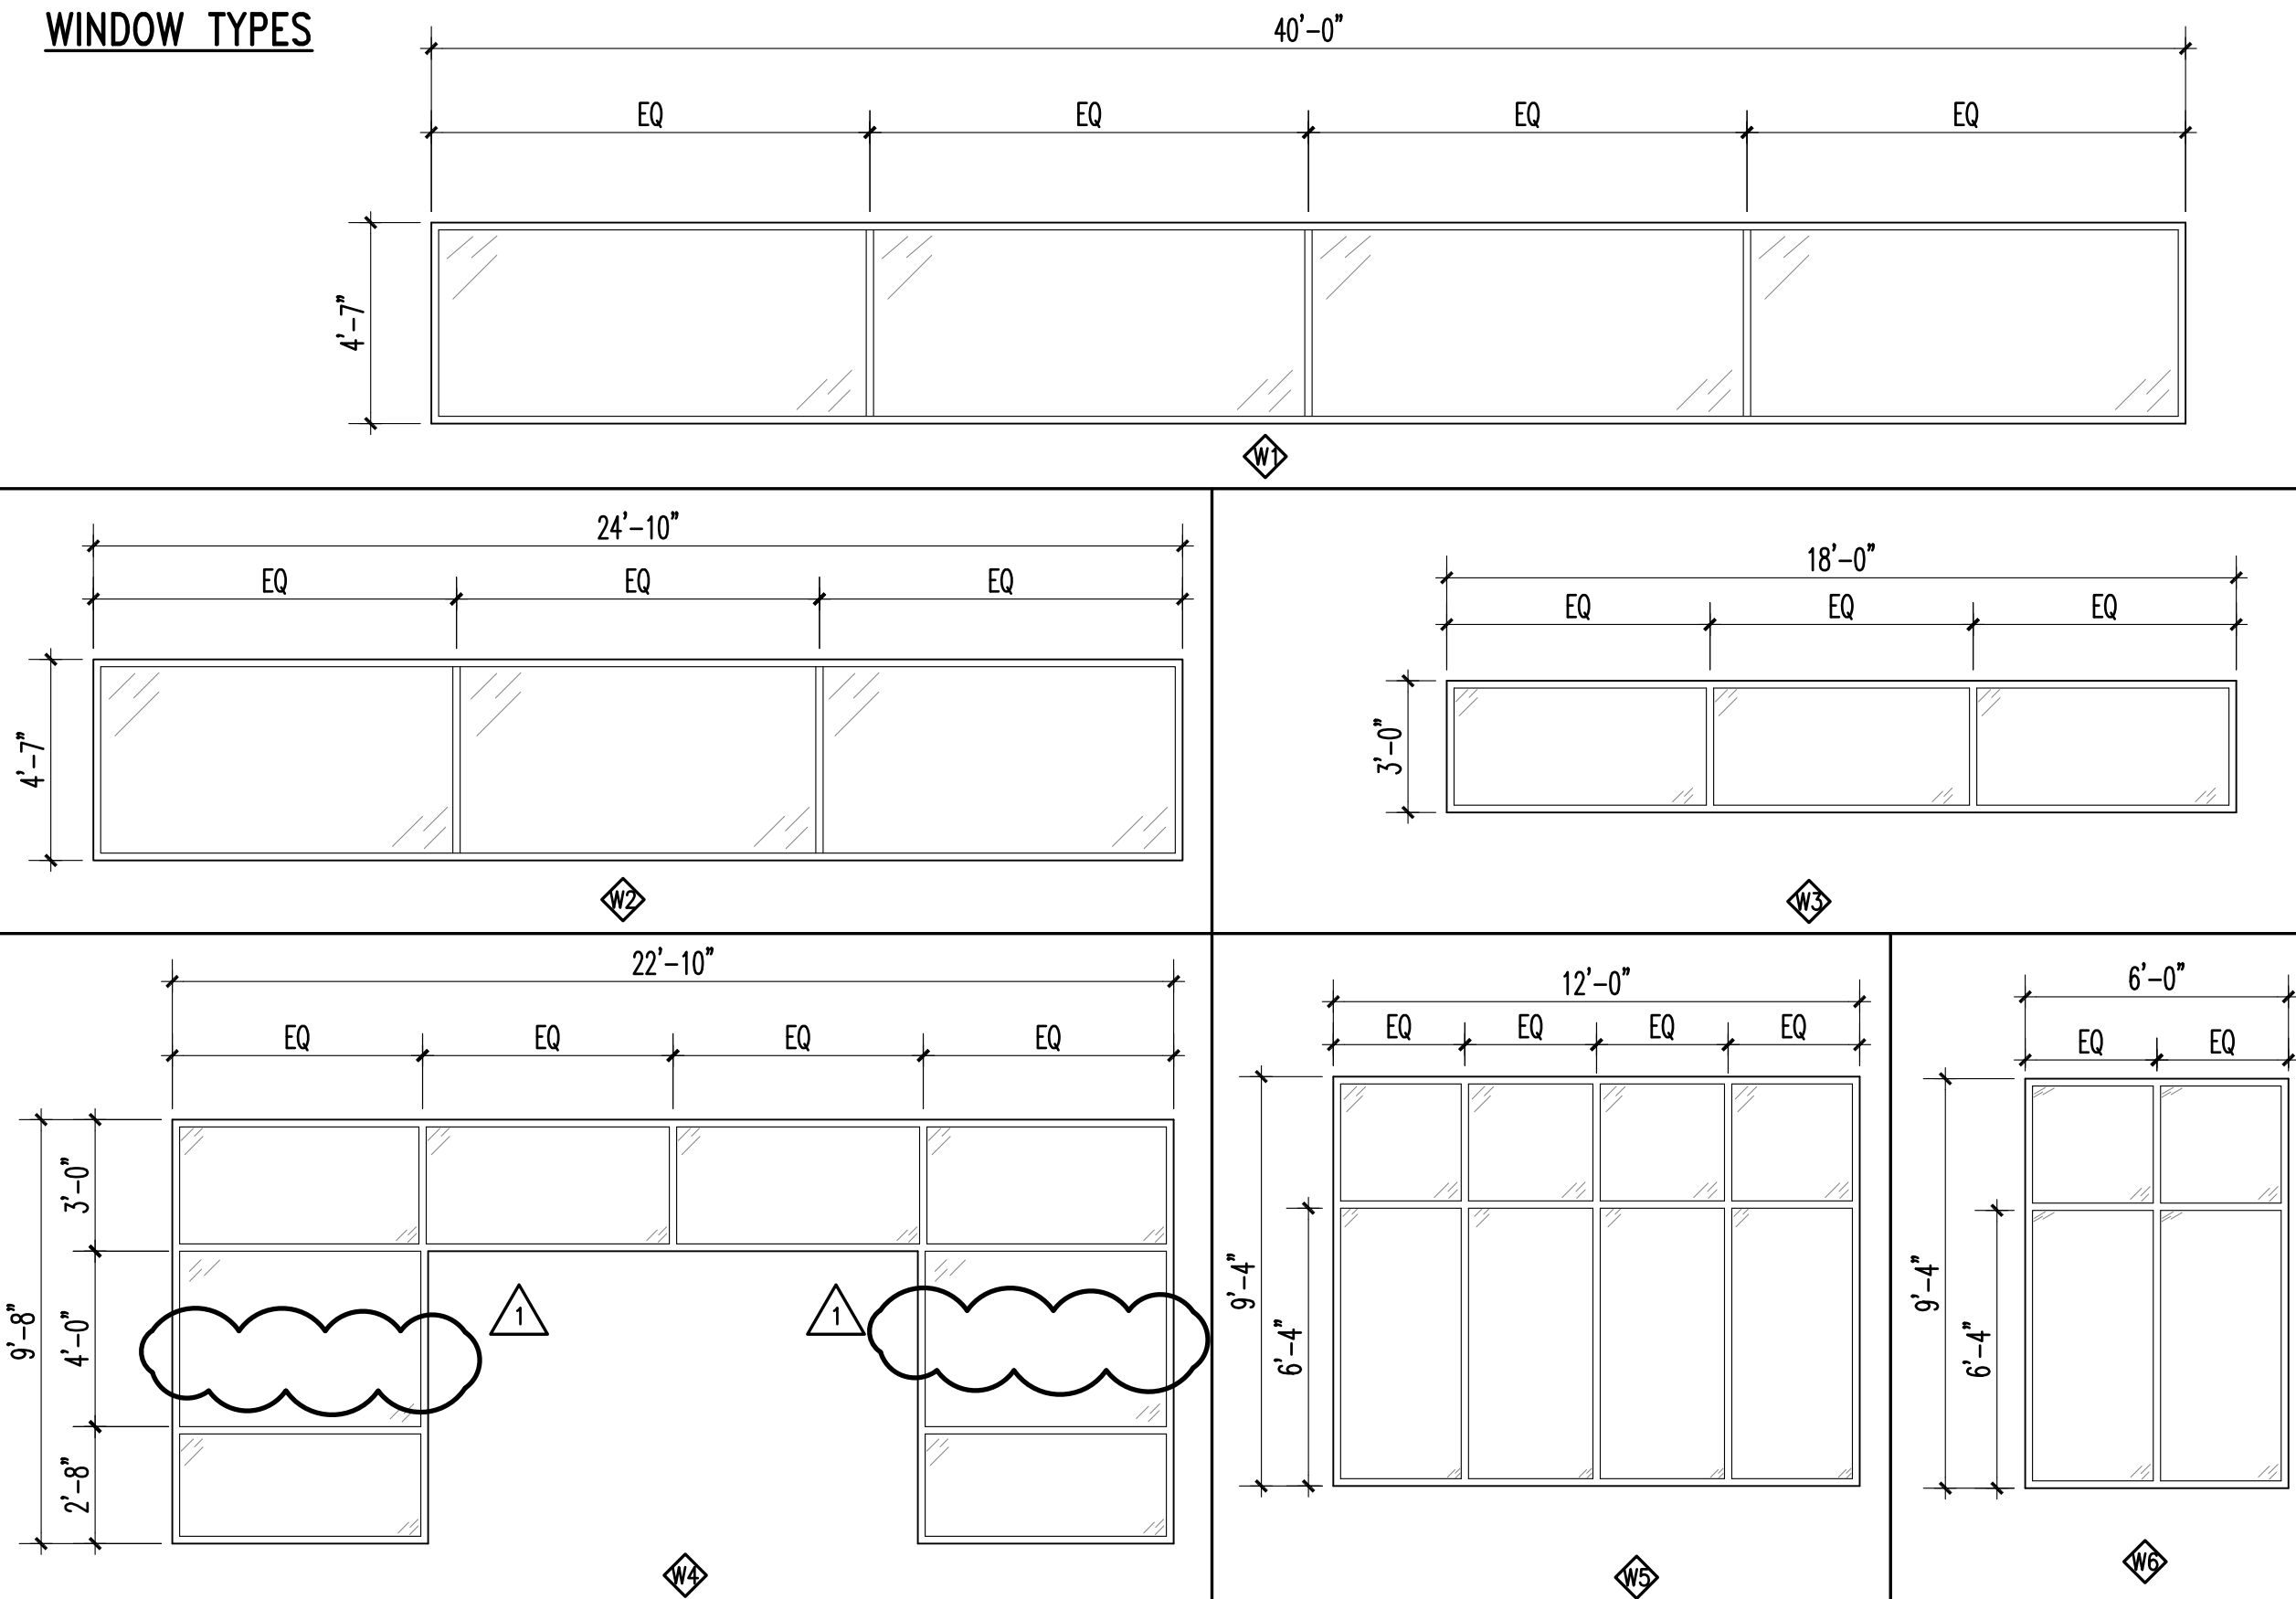


STOREFRONT TYPES

(NOTE: PROVIDE TEMPERED GLAZING FOR ALL GLAZING ADJACENT TO SWINGING DOORS.)

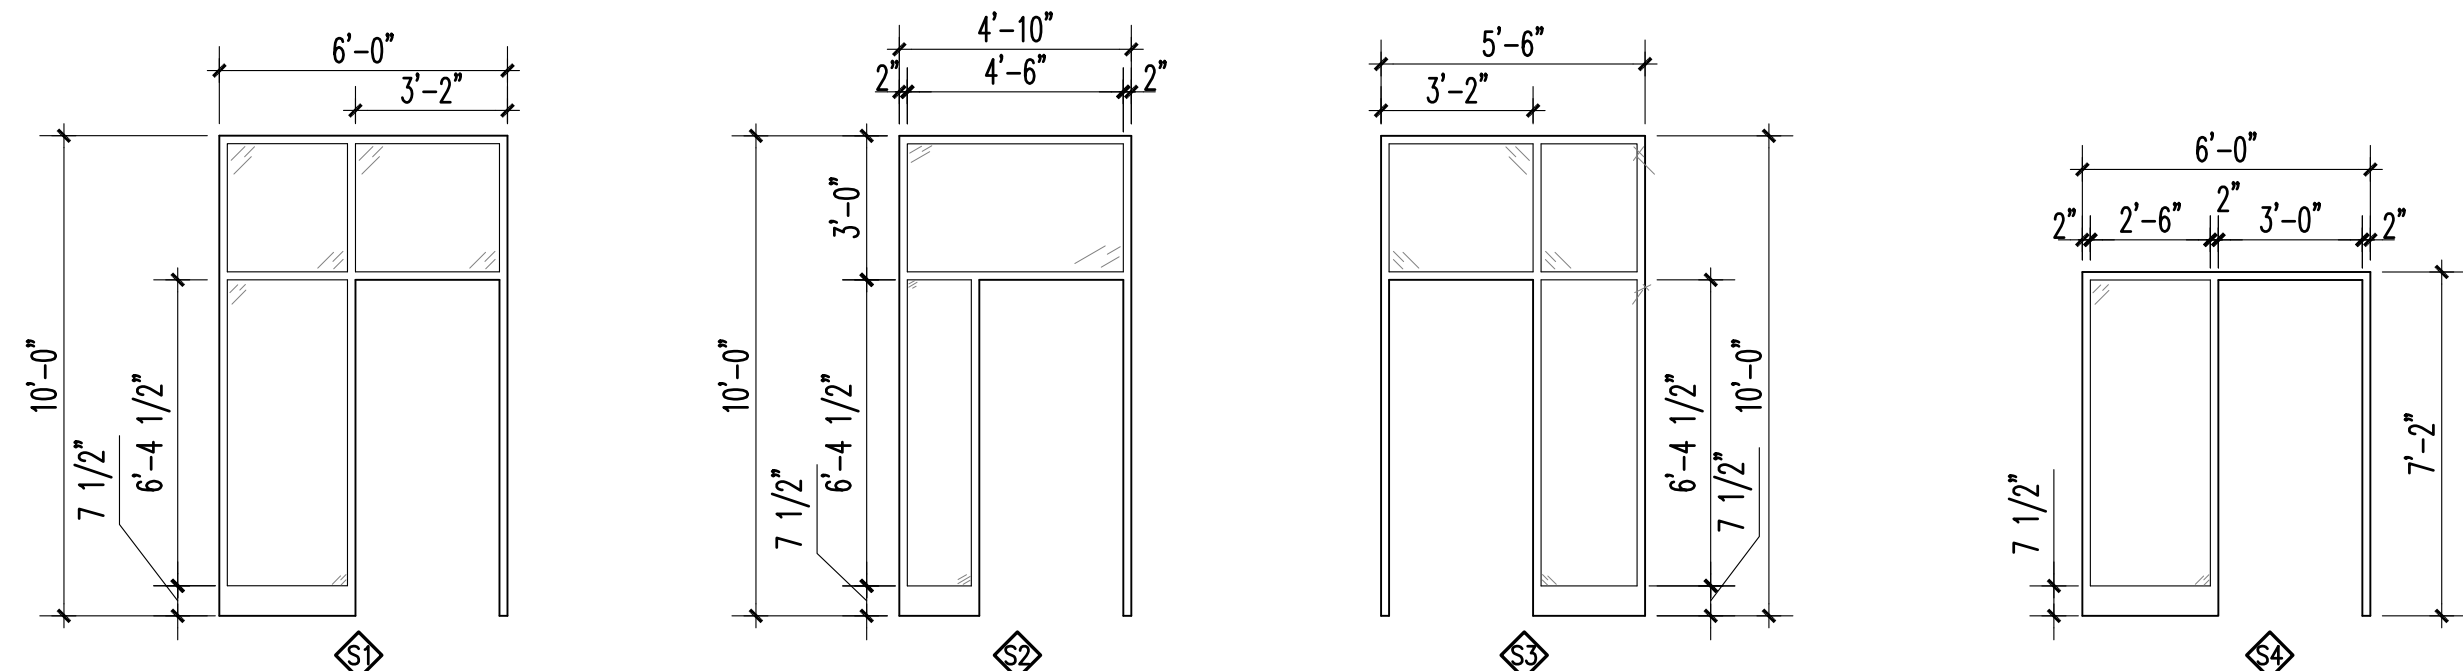

DOOR TYPES

FRAME TYPES

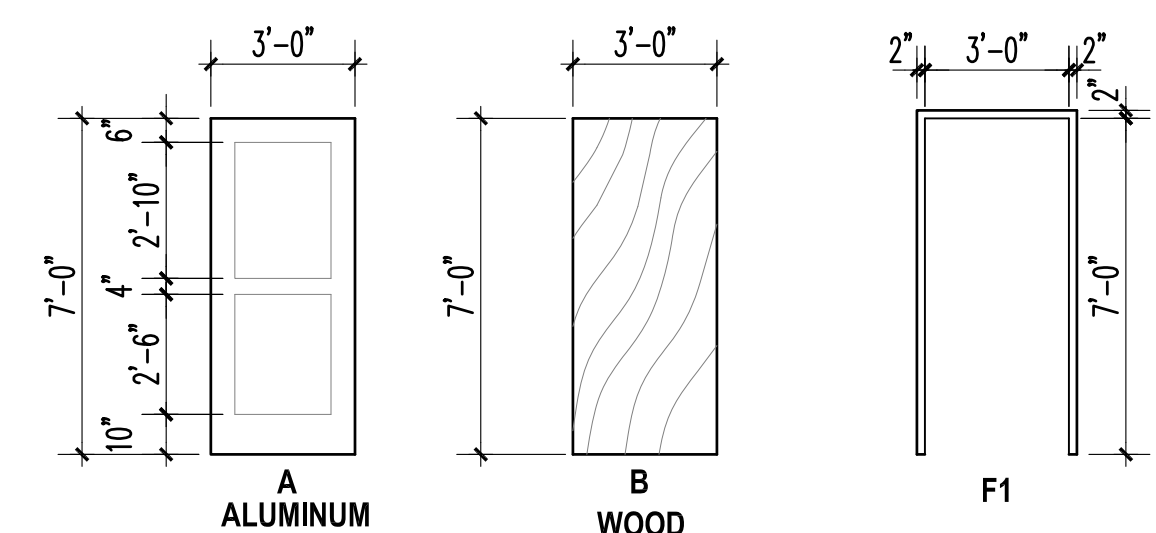

FINISH SCHEDULE - BASIS OF DESIGN

LEGEND	DESCRIPTION
ACT-1	ACOUSTICAL CEILING TILE- ARMSTRONG CEILING SYSTEMS, CALLA TEGULAR LAY-IN, 24"x24", WHITE
ACT-2	ACOUSTICAL CEILING TILE- ARMSTRONG CEILING SYSTEMS, CLEANROOM VL SQUARE LAY-IN, 24"x24", WHITE
LVT	LUXURY VINYL TILE- SHAW JEORGIGI FLAX 90700 18" X 18"
PNT-1	PAINT- SHERWIN WILLIAMS SW 6196, FROSTY WHITE
RB	RESILIENT RUBBER WALL BASE- JOHNSONITE 6" MILLWORK PROFILE-REVEAL, COLOR: 20 CHARCOAL
SS-1	SOLID SURFACE, LG HAUSYS, HI-MACS, L016 LUSTER
GR-1	GROUT, LATICRETE, 57 HOT COCOA (FLOOR TILE GROUT)
GR-2	GROUT, LATICRETE, 41 KASHMIR (WALL TILE GROUT)
T-1	FLOOR TILE, CROSSVILLE, AV247, HAZE UPS, 12"x24"
T-2	WALL TILE, CROSSVILLE, AV243, FOG UPS, 12"x24"
T-3	WALL TILE MOSAIC, CROSSVILLE, SBV1/10103HMOS, WARM GRAYS, 11-7/8"x11-7/8"
TB-1	TILE BASE, CROSSVILLE, AV243, FOG UPS, 6"x12"
SGYP	SUSPENDED GYPSUM BOARD
TP-1	TOILET PARTITION, ASI HOPE METALLIC SILVER 9511 PEBBLE GRAINED
PL-1	PLASTIC LAMINATE- WILSONART 17005K-57, MORRIS OAK

FINISHES INDICATED ARE THE APPROVED BASIS OF DESIGN TO CONVEY COLOR, PATTERN, TEXTURE, AND SALIENT CHARACTERISTICS ONLY. THE LISTING OF MANUFACTURER INFORMATION IS NOT INTENDED TO LIMIT THE SELECTION OF PRODUCT PROVIDED BY OTHER MANUFACTURERS. PRODUCTS MEETING THESE CRITERIA WILL BE CONSIDERED AND MUST BE REVIEWED AND APPROVED BY THE CONTRACTING OFFICER.

FINISH SCHEDULE

NOTE: " - " = NOT APPLICABLE

SPACE	FLOOR	BASE	WALLS	SOUTH	EAST	WEST	CEILING	REMARKS
NO.	NAME	MAT	MAT	NORTH	MAT	MAT	MAT	
101	CLASSROOM	LVT	RB	PNT-1	PNT-1	PNT-1	PNT-1	ACT-1
102	CLASSROOM	LVT	RB	PNT-1	PNT-1	PNT-1	PNT-1	ACT-1
103	CORRIDOR	LVT	RB	PNT-1	PNT-1	PNT-1	PNT-1	ACT-1
104	OFFICE	LVT	RB	PNT-1	PNT-1	PNT-1	PNT-1	ACT-1
105	CLASSROOM	LVT	RB	PNT-1	PNT-1	PNT-1	PNT-1	ACT-1
106	OPEN OFFICE	LVT	RB	PNT-1	PNT-1	PNT-1	PNT-1	ACT-1
106-A	OFFICE	LVT	RB	PNT-1	PNT-1	PNT-1	PNT-1	ACT-1
107	OFFICE	LVT	RB	PNT-1	PNT-1	PNT-1	PNT-1	ACT-1
108	MENS HEAD	LVT	RB	PNT-1	PNT-1	PNT-1	PNT-1	ACT-1
109	WOMENS HEAD	T-1	T-2	T-2	T-2	T-2	T-2	GYP/PT-1
110	JANITOR	T-1	T-2	T-2	T-2	T-2	T-2	GYP/PT-1
111	VENDING	-	-	PNT-1	PNT-1	PNT-1	PNT-1	GYP/PT-1
112	CLASSROOM	LVT	RB	PNT-1	PNT-1	PNT-1	PNT-1	ACT-1
113	CLASSROOM	LVT	RB	PNT-1	PNT-1	PNT-1	PNT-1	ACT-1
114	CLASSROOM	LVT	RB	PNT-1	PNT-1	PNT-1	PNT-1	ACT-1
115	CLASSROOM	LVT	RB	PNT-1	PNT-1	PNT-1	PNT-1	ACT-1
116	CLASSROOM	LVT	RB	PNT-1	PNT-1	PNT-1	PNT-1	ACT-1
117	CLASSROOM	LVT	RB	PNT-1	PNT-1	PNT-1	PNT-1	ACT-1
118	MECHANICAL ROOM	LVT	RB	PNT-1	PNT-1	PNT-1	PNT-1	ACT-1
119	RUBBER SHOP	-	-	PNT-1	PNT-1	PNT-1	PNT-1	ACT-1
120	VESTIBULE	-	-	PNT-1	PNT-1	PNT-1	PNT-1	-
121	OPEN OFFICE	LVT	RB	PNT-1	PNT-1	PNT-1	PNT-1	ACT-1
122	CORRIDOR	LVT	RB	PNT-1	PNT-1	PNT-1	PNT-1	ACT-1
123	VESTIBULE	LVT	RB	PNT-1	PNT-1	PNT-1	PNT-1	ACT-1
124	SUPERVISOR	LVT	RB	PNT-1	PNT-1	PNT-1	PNT-1	ACT-1
125	ADMIN	LVT	RB	PNT-1	PNT-1	PNT-1	PNT-1	ACT-1
126	OPEN OFFICE	LVT	RB	PNT-1	PNT-1	PNT-1	PNT-1	ACT-1
127	OPEN OFFICE	LVT	RB	PNT-1	PNT-1	PNT-1	PNT-1	ACT-1
127A	OFFICE	LVT	RB	PNT-1	PNT-1	PNT-1	PNT-1	ACT-1
128	STORAGE	LVT	RB	PNT-1	PNT-1	PNT-1	PNT-1	ACT-1
129	STORAGE	-	-	PNT-1	PNT-1	PNT-1	PNT-1	ACT-1
130	STORAGE	-	-	PNT-1	PNT-1	PNT-1	PNT-1	ACT-1
131	OPEN OFFICE	-	-	PNT-1	PNT-1	PNT-1	PNT-1	ACT-1
132	LOCKER ROOM	LVT	RB	PNT-1	PNT-1	PNT-1	PNT-1	ACT-1
133	LOCKER ROOM	T-1	T-2	T-2	T-2	T-2	T-2	GYP/PT-1
134	TOILET	T-1	T-2	T-2	T-2	T-2	T-2	GYP/PT-1
135	MENS HEAD	T-1	T-2	T-2	T-2	T-2	T-2	GYP/PT-1
136	BLAST DOWN	-	-	PNT-1	PNT-1	PNT-1	PNT-1	-
137	GEAR	T-1	T-2	T-2	T-2	T-2	T-2	GYP/PT-1
138	TOILET	T-1	T-2	T-2	T-2	T-2	T-2	GYP/PT-1
139	LOCKER ROOM	T-1	T-2	T-2	T-2	T-2	T-2	GYP/PT-1
140	LOCKER ROOM	T-1	T-2	T-2	T-2	T-2	T-2	GYP/PT-1
141	WOMENS HEAD	T-1	T-2	T-2	T-2	T-2	T-2	GYP/PT-1
142	BREAK ROOM	LVT	RB	PNT-1	PNT-1	PNT-1	PNT-1	ACT-1
143	COMM. ROOM	LVT	RB	PNT-1	PNT-1	PNT-1	PNT-1	GYP/PT-1
144	BLAST EQUIPMENT	-	-	PNT-1	PNT-1	PNT-1	PNT-1	-
145	SPRINKLER ROOM	-	-	PNT-1	PNT-1	PNT-1	PNT-1	-
146	ELECTRICAL ROOM	-	-	PNT-1	PNT-1	PNT-1	PNT-1	-
147	PLASTIC MEDIA BLASTING FACILITY	-	-	PNT-1	PNT-1	PNT-1	PNT-1	ACT-2
148	STEAM ROOM	-	-	PNT-1	PNT-1	PNT-1	PNT-1	-
149	VESTIBULE	-	-	PNT-1	PNT-1	PNT-1	PNT-1	-
150	COVERED SPACE	-	-	-	-	-	-	-
201	MEZZANINE	LVT	RB	PNT-1	PNT-1	PNT-1	PNT-1	ACT-1
202	MEZZANINE	-	-	PNT-1	PNT-1	PNT-1	PNT-1	-

DOOR SCHEDULE

NOTE: CONTRACTOR SHALL FIELD VERIFY ALL DOOR AND FRAME DIMENSIONS, AND WALL TYPES IN FIELD PRIOR TO ORDERING UNITS. SEE PLAN LOCATIONS FOR SPECIFIC HANDING AND ORIENTATION.

DOOR DATA	FRAME DATA	DETAILS		
NUM.	TYPE	SIZE	THK.	MAT.
103A	A	3'-0"x7'-0"	1-3/4"	ALUM
103B	A	3'-0"x7'-0"	1-3/4"	ALUM
106A	B	3'-0"x7'-0"	1-3/4"	WOOD
108A	B	3'-0"x7'-0"	1-3/4"	WOOD
109A	B	3'-0"x7'-0"	1-3/4"	WOOD
110A	B	3'-0"x7'-0"	1-3/4"	WOOD
120A	A	3'-0"x7'-0"	1-3/4"	ALUM
120B	A	3'-0"x7'-0"	1-3/4"	ALUM

WINDOW SCHEDULE

NOTE: CONTRACTOR SHALL FIELD VERIFY ALL WINDOW ROUGH OPENING DIMENSIONS IN FIELD PRIOR TO ORDERING UNITS.

WINDOW DATA	DETAILS			
MARK	SIZE (wxh)	MATERIAL	FINISH	GLASS
40'-0" X 4'-7"	ALUM	ANODIZED	1" INSUL.	A4/A-602
24'-10" X 4'-7"	ALUM	ANODIZED	1" INSUL.	A4/A-602
18'-0" X 3'-10"	ALUM	ANODIZED	1" INSUL.	A4/A-602
22'-10" X 9'-8"	ALUM	ANODIZED	1" INSUL.	A4/A-602
12'-0" X 9'-4"	ALUM	ANODIZED	1" INSUL.	A4/A-602
6'-0" X 9'-4"	ALUM	ANODIZED	1" INSUL.	A4/A-602

STOREFRONT SCHEDULE

NOTE: CONTRACTOR SHALL FIELD VERIFY ALL STOREFRONT DIMENSIONS IN FIELD PRIOR TO ORDERING UNITS.

WINDOW DATA	DETAILS			
MARK	SIZE (wxh)	MATERIAL	FINISH	GLASS
6'-0" X 10'-0"	ALUM	ANODIZED	1" INSUL.	B3/A-601
4'-10" X 10'-0"	ALUM	ANODIZED	1" INSUL.	B3/A-601
5'-6" X 10'-0"	ALUM	ANODIZED	1" INSUL.	B3/A-601
6'-0" X 7'-2"	ALUM	ANODIZED	1" INSUL.	B3/A-601



U.S. MARINE CORPS AIR STATION
CHERRY POINT, NORTH CAROLINA
REPAIR AND UPGRADE
BUILDING 4034, FRC-E
WINDOW AND STOREFRONT SCHEDULE

SCALE: AS NOTED
PROJECT NO.: XK11237
MAXIMO WORK ORDER NO.: 7375939
NAVFAC DRAWING NO.: 12816264
SHEET 53 OF 114
A-601



NRW ENGINEERING
Structural Consultants
748 Lord Dunmore Drive, Suite 101
Virginia Beach, VA 23464
Phone 757-474-0612
Fax 757-474-0919

APPROVED

FOR COMMANDER NAVFAC

ACTIVITY

SATISFACTORY TO

DES DRW CHK