


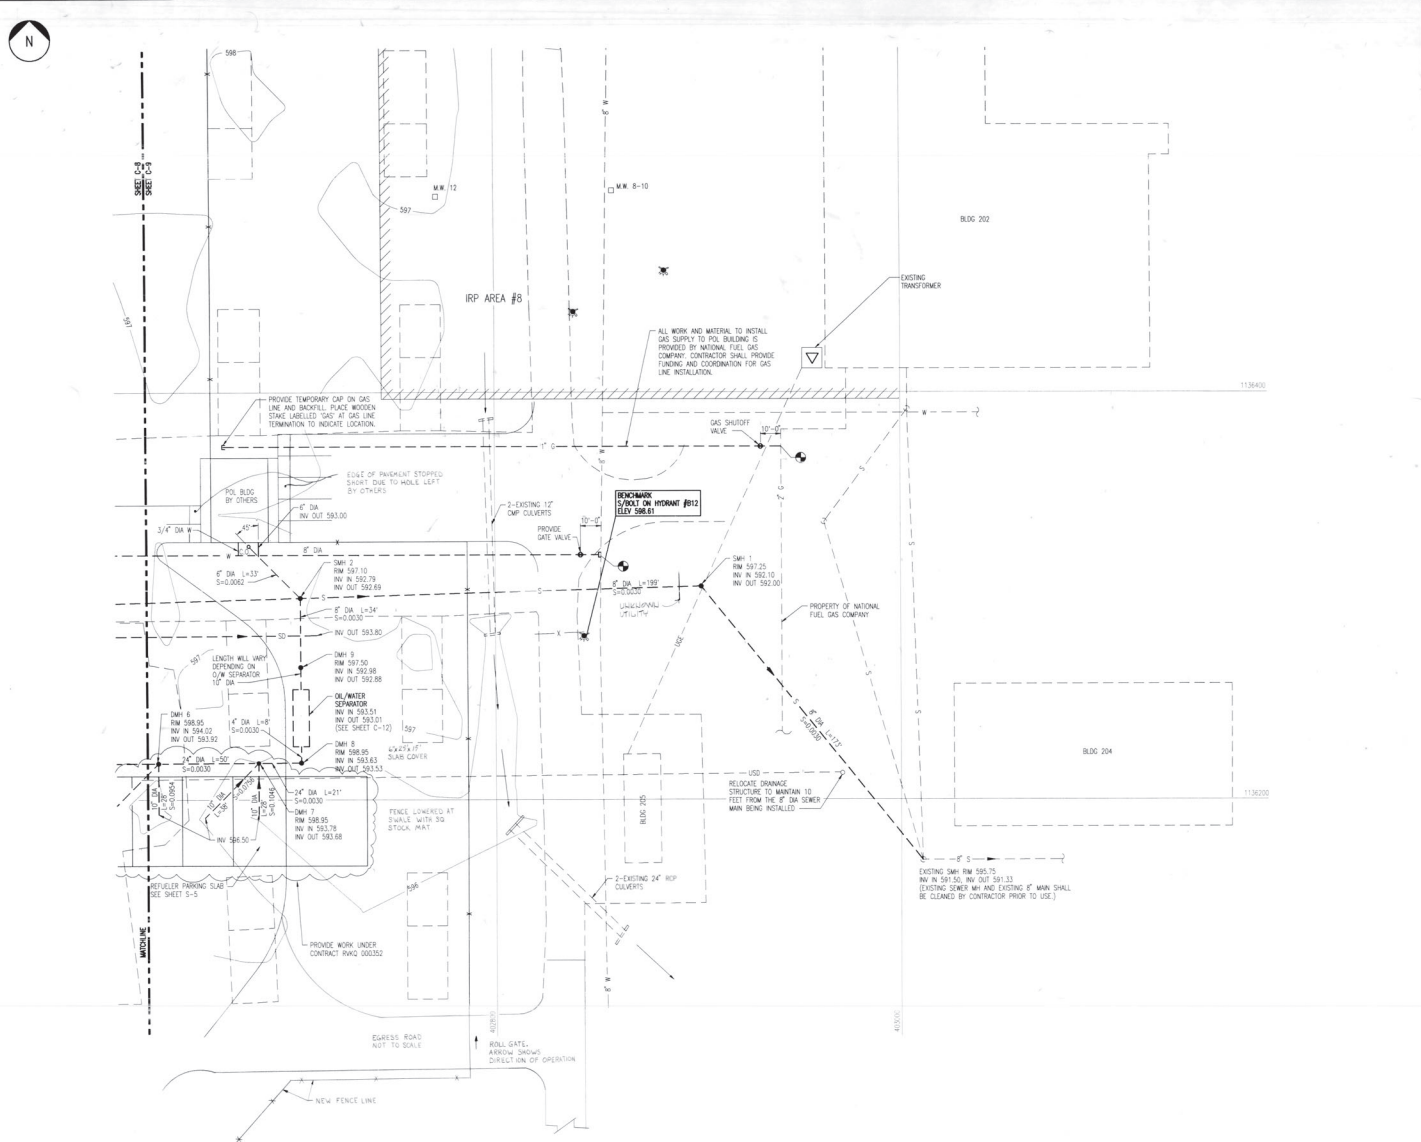

NOTES:

1. SEE LEGEND AND NOTES ON SHEETS C-3 AND C-4.
2. SEE SHEET C-4 FOR COORDINATE POINTS OF UTILITIES.
3. SEE SHEET C-10 FOR UTILITY PROFILES.
4. SEE PVC AND DUCTILE IRON PIPE TRENCHING DETAIL ON SHEET C-4.

RECORD DRAWING

This Record Drawing has been prepared in part based upon information furnished by others. While this information is believed to be reliable, the Engineer cannot assume its accuracy and therefore is not responsible for any errors or omissions which may have been incorporated into it as a result. Those utilizing this Record Drawing are advised to obtain independent verification of its accuracy before relying on it for any purpose.

GRAPHIC SCALE

20 0 20 40 FT

SCALE: 1"=30'

CHECK GRAPHIC SCALE BEFORE USING

REV	DATE	BY	DESCRIPTION
1			
2			
3			
4			
5			
6			
7			
8			
9			
10			

DESIGNED BY: DBB
DRAWN BY: RMA/TO
CHECKED BY: [Signature]
DATE: 10/1/95
SCALE: 1"=30'

ENTERPRISE ENGINEERS, INC.
1000 South Main Street
Niagara Falls, NY 14201
(716) 261-1111

CLIENT/PROJECT:
NEW YORK AIR NATIONAL GUARD
NIAGARA FALLS
107th FIGHTER GROUP
JET FUEL STORAGE COMPLEX
REVISIONS

DRAWING TITLE:
UNDERGROUND UTILITIES PLAN
PART B

DWG NO.	FILE	SHEET	REV
91-1335	AF	C-3	31-2-95